

Création du plan : 21/12/2006

Mise à jour réseaux : 15/03/2019

Dessinateur : V. AMBOS

Report des extensions : 17/04/2019

sur la base du Plan de Zonage

reçu le : 20/03/2019

Tableau d'assemblage :

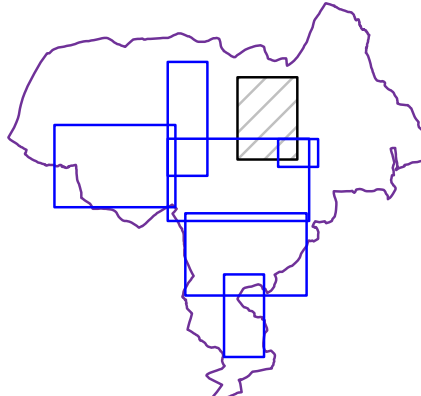


Planche : 5/7

Echelle : 1/2000

Légende P.L.U. :

Conduite AEP à prévoir

Conduite AEP à renforcer

Réseau d'eau potable

Réseau d'eau (Brute)

Réseau d'eau (Basse pression)

Réseau d'eau (Moyenne pression)

Réseau d'eau (Haute pression)

Conduite de vidange

Réseau non raccordé

Réseau hors compétence

Poteau d'incendie (PI)

Hydrant (H)

Clème incendie (Raccordée)

Clème incendie (Non raccordée)

Puits d'incendie (Non raccordé)

Vanne ouverte

Vanne fermée

Robinet prise

Regard de branchement Léger

Regard de branchement Béton

Bouchon

Plaque pleine

Séparateur de tronçons

Cône de réduction

Ventouse

Vidange, Purge ou Aération

Hydrant d'Aération (HA)

Réducteur ou Stabilisateur de pression

Borne fontaine

Regard de comtage

Regard de régulation

Station de pompage

Station relais

Station de traitement

Source

Puits

Brise-charge

Collecteur

Réservoir


Câble ouvrage

At.

Attachement

Plan de récolement

Reproduction soumise à l'autorisation préalable du SDEA * SCAN25 - IGN Paris - Reproduction Interdite - Licence n°9278

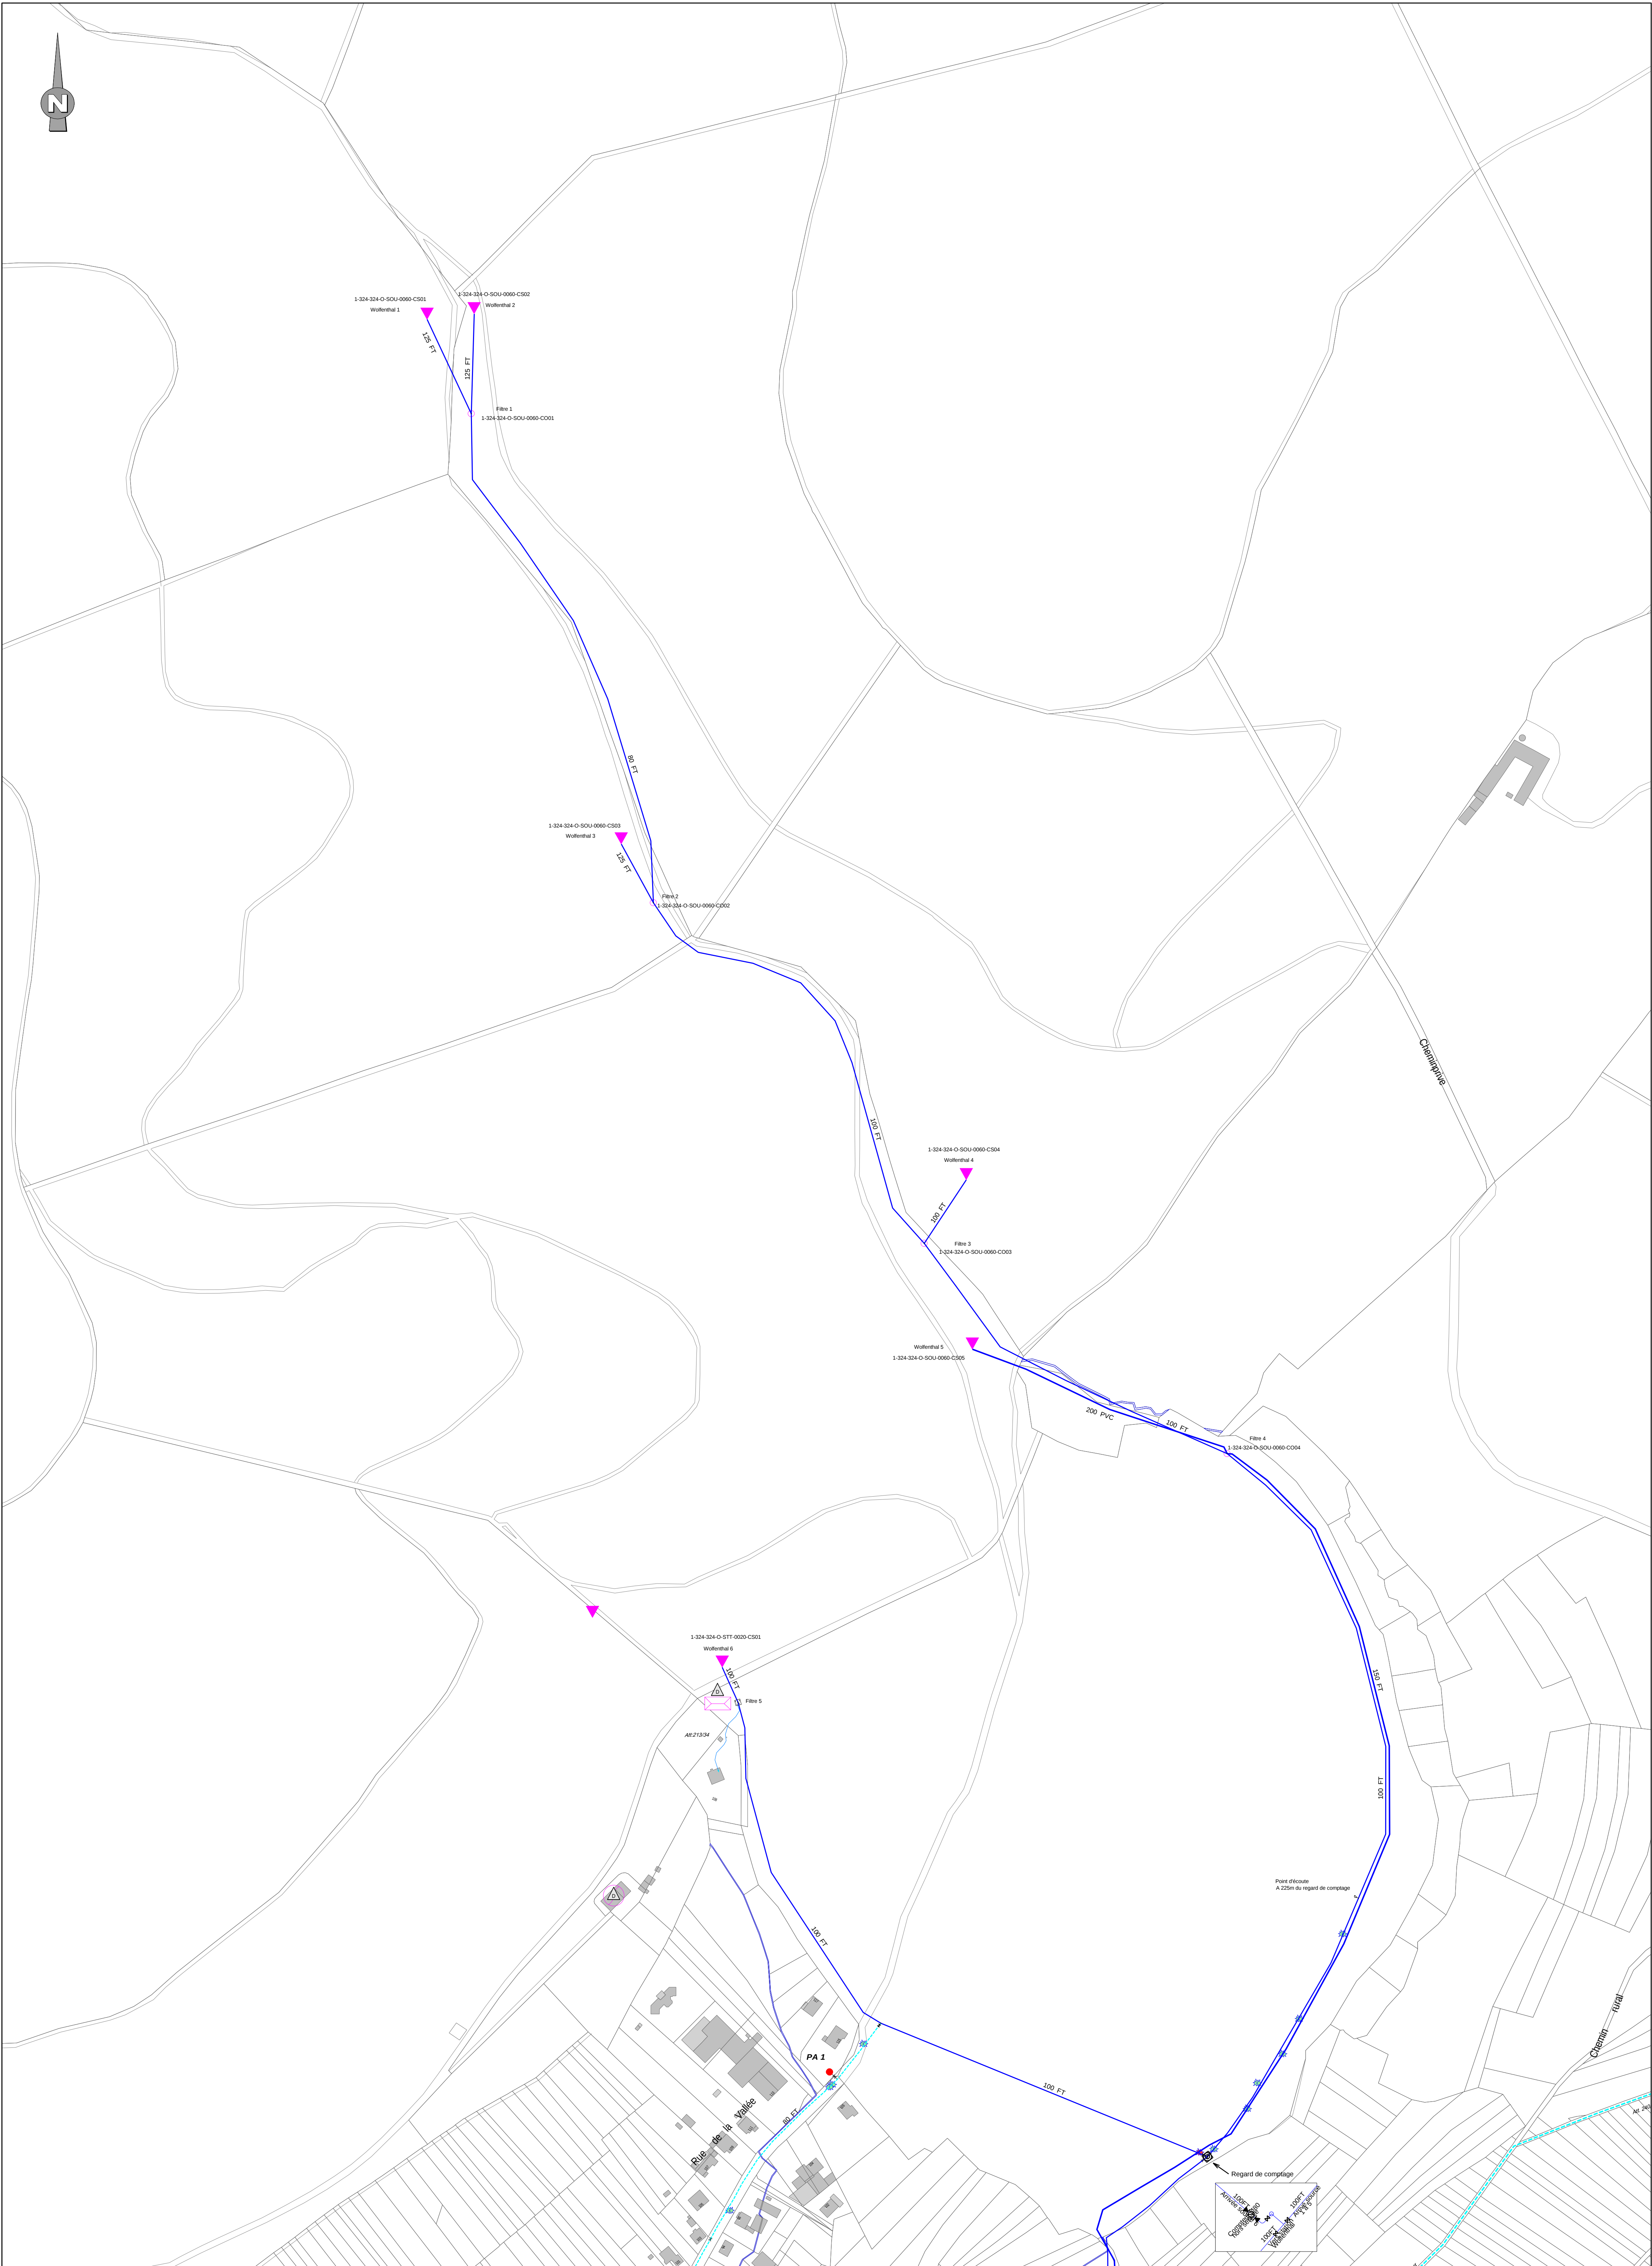



